


PRESTONWOOD TOWER



5151 BELT LINE ROAD, DALLAS, TX 75254

SUITE 101 | 8,695 RSF

Spec Design

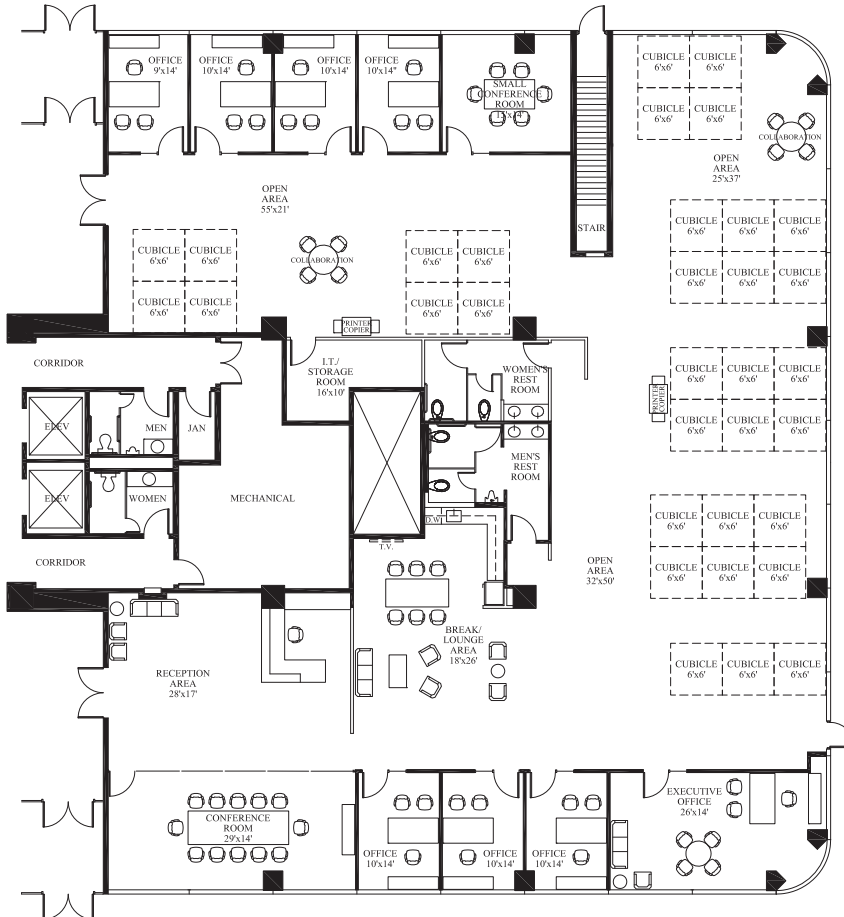

As Built

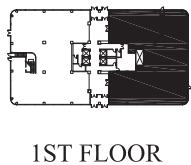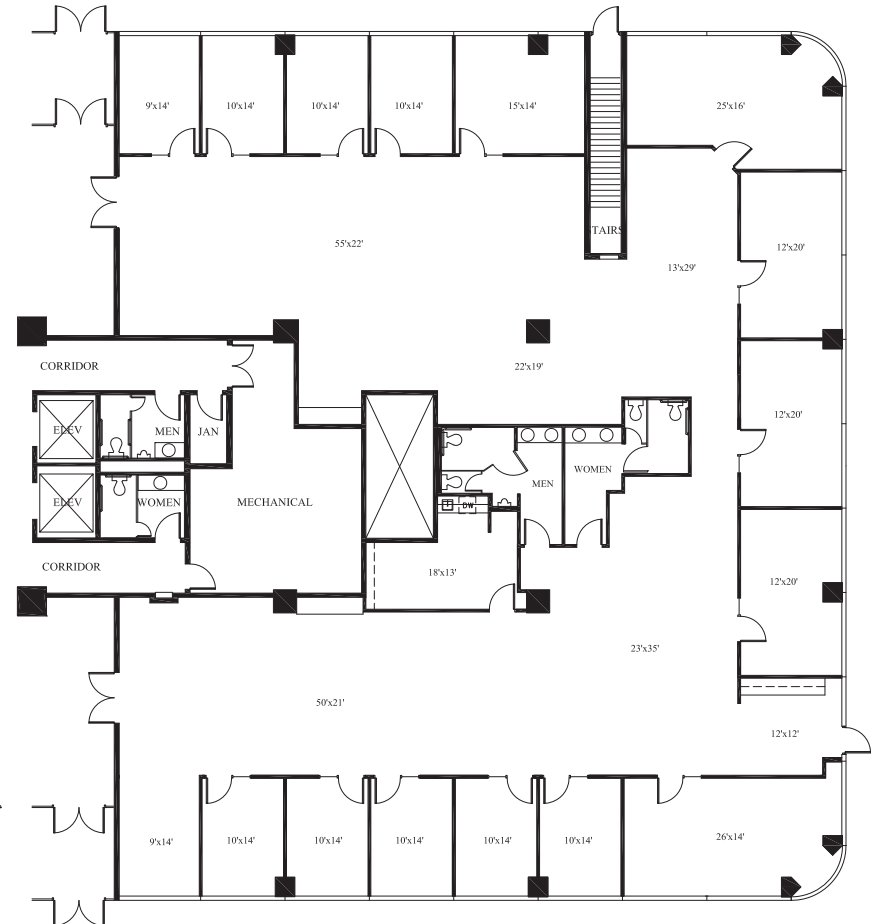

— EXISTING WALLS TO REMAIN
- - - NEW WALLS