


## PRESTONWOOD TOWER



5151 BELT LINE | DALLAS, TX 75254

SUITE 347 | 1,367 RSF

SPEC DESIGN

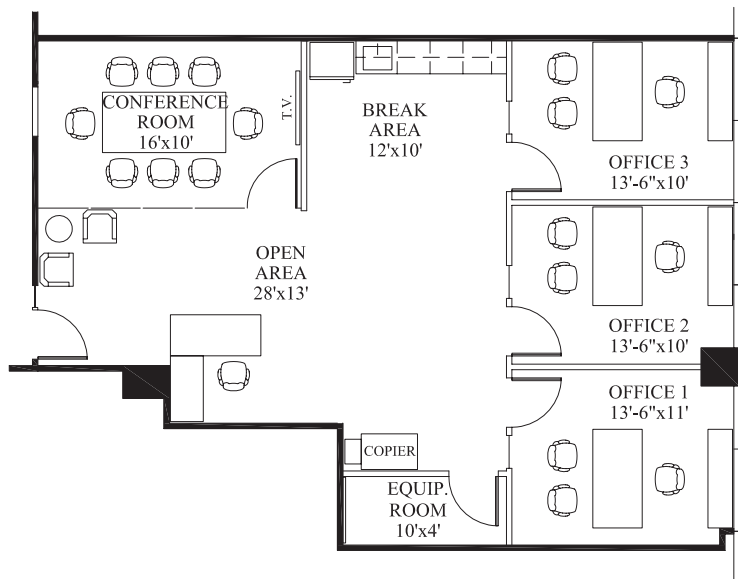

AS-BUILT

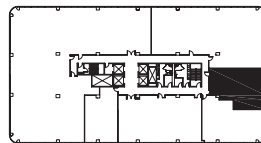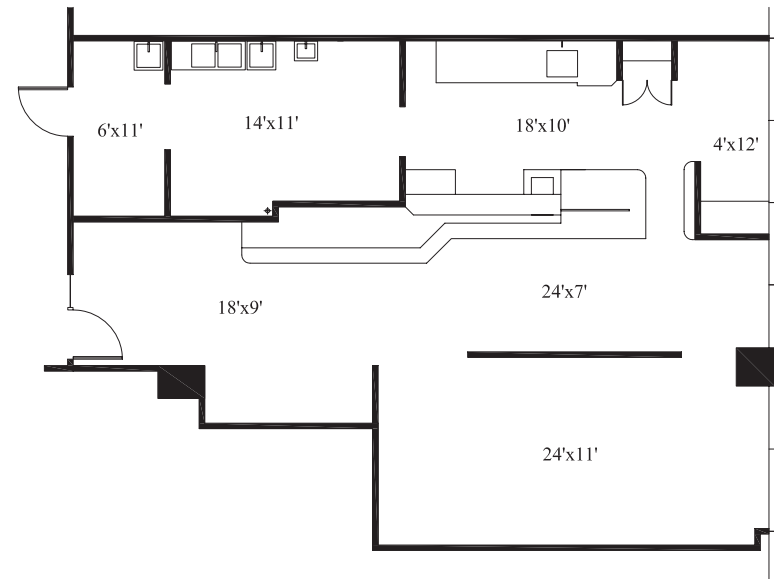

3RD FLOOR