


PRESTONWOOD TOWER



5151 BELT LINE | DALLAS, TX 75254

SUITE 1005 | 3,303 RSF

AS-BUILT

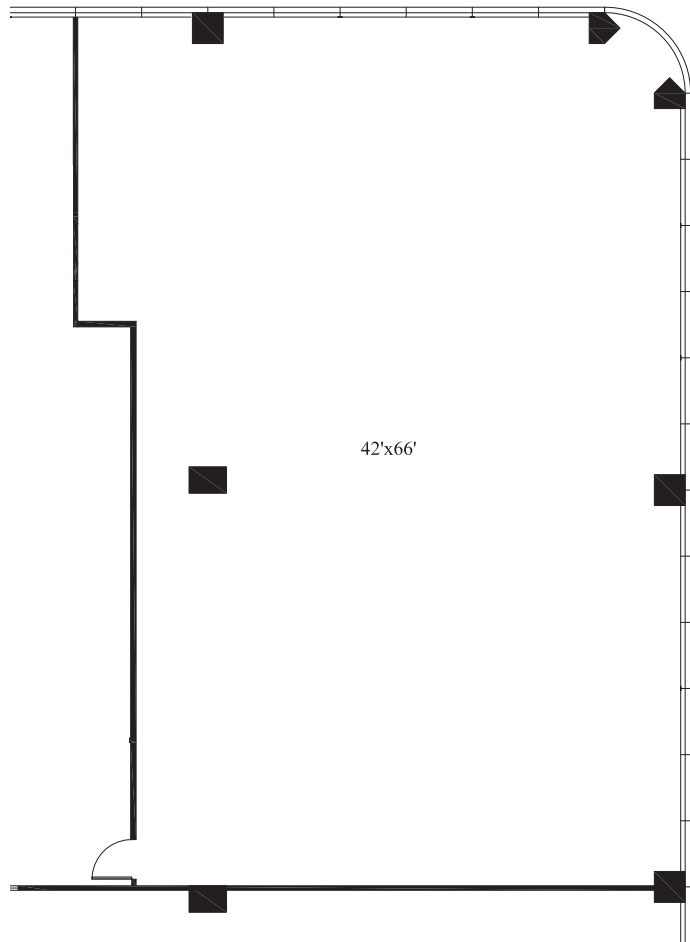

SPEC DESIGN

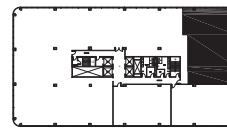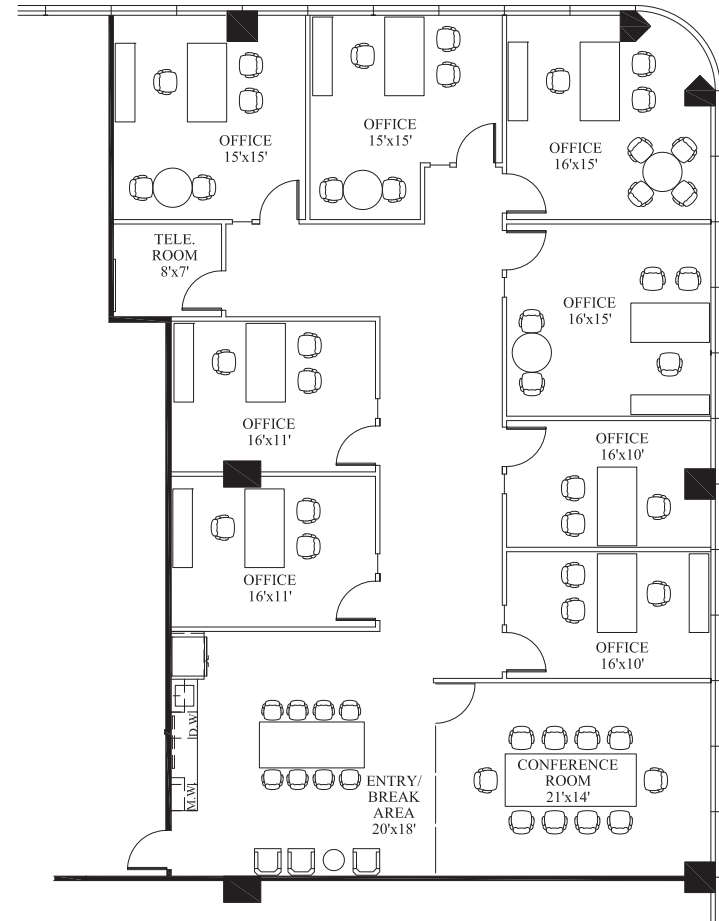

10TH FLOOR